



de maximis, inc.

450 Montbrook Lane
Knoxville, TN 37919
(865) 691-5052

February 23, 2020

Mr Rusty Kestle
U.S. Environmental Protection Agency
Region IV
61 Forsyth Street, S.W.
Atlanta, Georgia 30303-3104

Re.: January 2020 Monthly Progress Report

Dear Rusty:

Please find attached the January 2020 Monthly Progress Report for the Cabot portion of the Cabot/Koppers Superfund Site in Gainesville, Florida.

Please feel free to contact me (610) 417-4767 or Robert Rule (865) 691-5052 with questions.

Sincerely,

Kelly L. Fifer

Cc: Wayne Reiber
Robert Rule
Mark Taylor
Carl Elder
Steve Poirier
Manu Sharma
Meghna Swamy
Tracie Vaught
Rick Hutton
Gus Olmos
Ted Goodman
Bryan Cotter

**January 2020 Monthly Progress Report
Cabot Portion of Cabot/Koppers Superfund Site, Gainesville, FL**

Data Inventory

Perimeter air monitoring samples were collected on January 9, 2020 and January 23, 2020. Canister samples were collected in a 6-L SUMMA canister and analyzed using EP Method TO 15.

Data Reporting

Table 1 shows the volume of groundwater collected and treated during the first quarter.

Table 1 Groundwater Collected and Discharged to GRU

Time Period	Volume of Groundwater (million gallons)
January 2020	2.44
February 2020	
March 2020	
First Quarter Total	2.44

Note: Daily and monthly discharge volumes
are reported to GRU quarterly.

The perimeter air monitoring results are provided in a separate Excel spreadsheet file.

Construction Activities


- Completed installation of VBW (1/13/2020)
- Completed stabilizing VBW spoils
- Installed new construction entrance west of the original site entrance along NE 1st Blvd
- Surveyor collected as-built shots along center line of slurry wall
- Completed placement of protective cover in new pond
- Continued subgrade grading at the north side of the City's pond (Section 1) in preparation for geosynthetics installation
- Removed sump and stone from decon pad at the north side of site (Section 1) in preparation for geosynthetics installation
- Tree stumps were sized for placement beneath the cap areas
- Well drillers (EDS) completed drilling of extraction wells UHG-EW-05, UHG-EW-06 (well was moved approximately 44 ft to the east due to a tree canopy not allowing the well to be placed at it's original location), UHG-EW-07, UHG-EW-08

Upcoming Construction Activities

- Complete subgrade grading in Section 1
- Begin geosynthetics installation in Section 1
- Install sod in new pond
- Continue grading subgrade in Sections 2 and 3
- Collect perimeter air samples

Issues/Concerns

- No issues

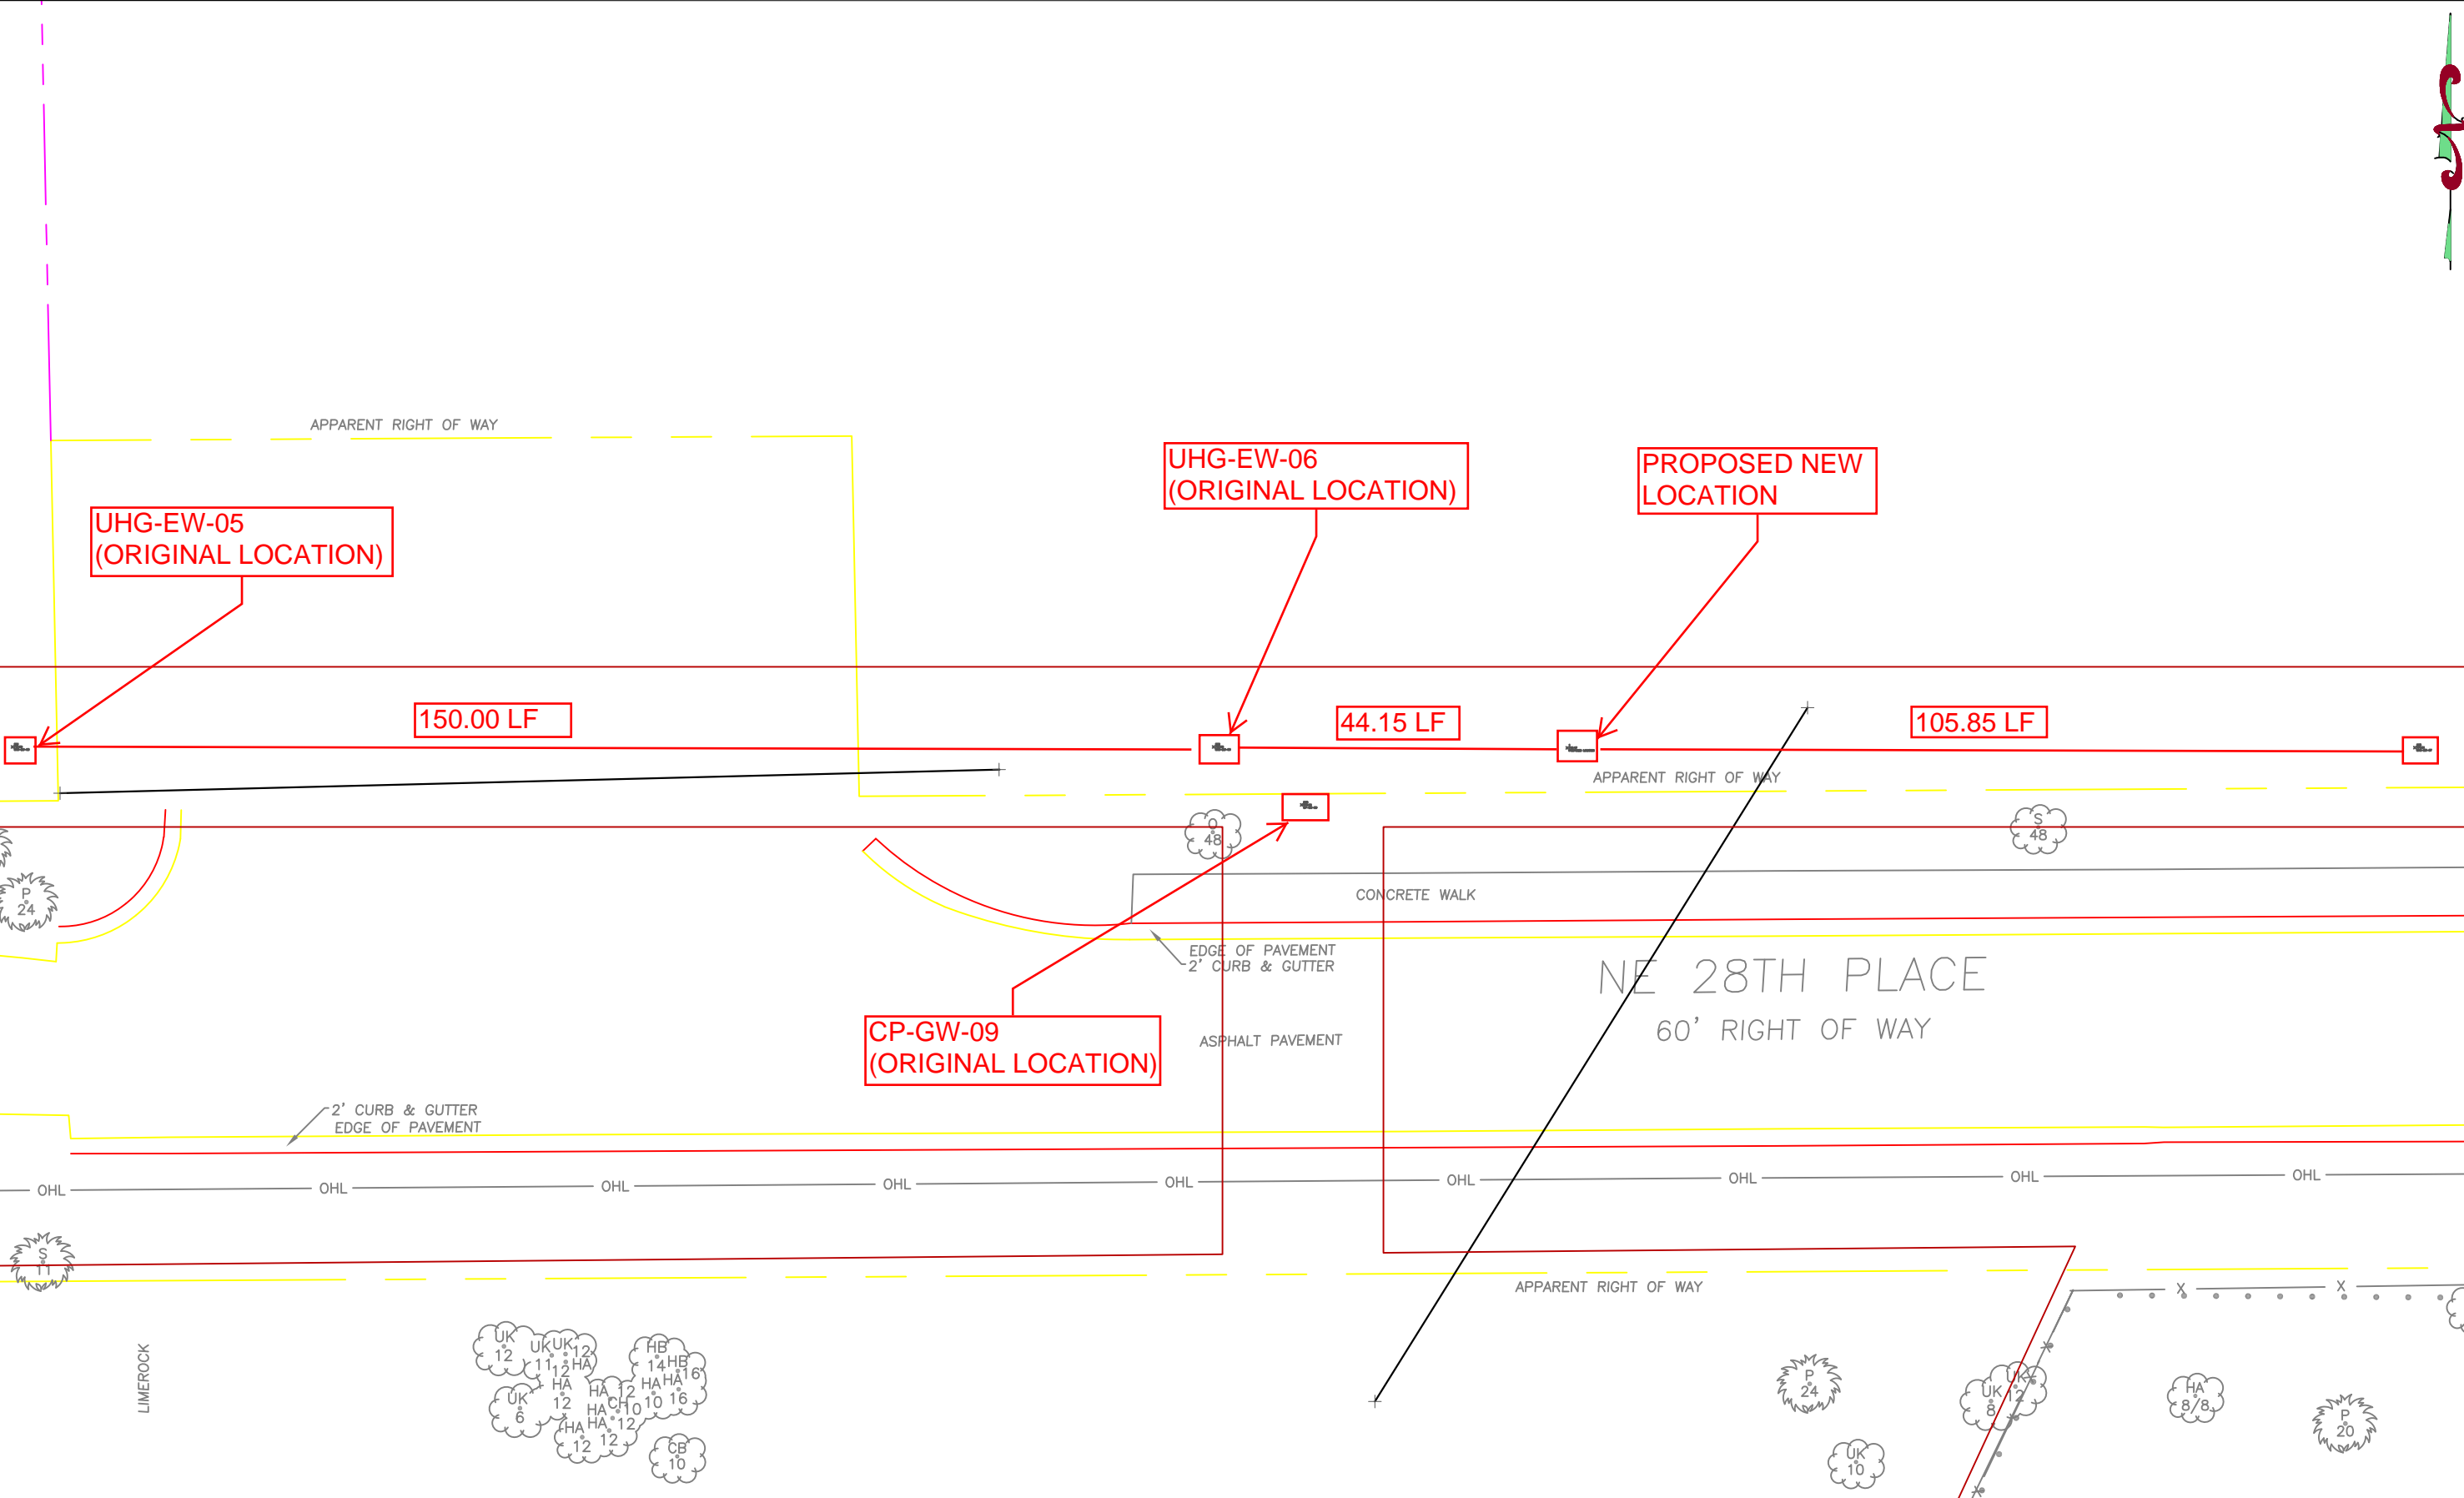

TITLE
 CABOT CARBON SUPERFUND SITE
 GAINESVILLE, FL
 PROPOSED NEW LOCATION OF
 EXTRACTION WELL
 JAN 2020

9977 W. Sam Houston Parkway N. Suite 100
 Houston, Texas 77064-7509
 Phone: (281)955-2442 Fax: (281)890-5172
 www.reconservices.com

FIELD BOOK: _____
 DRAWN: Brad Houston
 CHECKED: _____

PAGE: 1 OF 1
 DATE: 12 JAN 2020
 SCALE: NTS

RECON
 Remedial Construction Services, L.P.

SIGNED BY: *Brad Houston*